RTPNW-12
RTPNW-13
I-40
Duke Net
2234'
Sumitomo-096
RTPNW-11A
106'
Sumitomo-096
RTPNW-11
1290'
2234'
LHWB-WY6-036
Not installed
3022'
MHGB-W5T-048
RTP Central Loop
Detail 2
Jester Rd
E No State Hwy 54
To Meadowmont and Chapel Hill
Progress Energy Route
Detail 2
LHWB-WY6-036
RTPNW-14
1550'
LHWB-WY6-036
1320'
LHWB-WY6-036
RTPNW-15
MHGB-W5T-048
RTPNW-3
1290'
Corning Optical-036
Verizon
2314 Hwy 54
OC-12, Ring 1, NE 10
RTP-Verizon PW, NE 100
OC-48 Ring 1, NE 1002
Ring 11, NE 1008
1086'
1482'
MHGB-W5T-048
RTPNW-10
RTPNW-4
RTP Central Loop
Detail 1
State Highway 55
S Alston Ave
Englert Dr
Triangle Dr
1424'
LHWB-WY6-036
Detail 1
RTPNW-5
474'
RTPNW-6
2110'
Corning Optical
RTPNW-9
Prospective Dr
3298'
LHWB-WY6-036
RTPC-9A
RTP Central Loop
RTPC-9
Spl point to
RTPC
1482'
RTP Central Loop
RTPC-8
Spl point to
RTPC
1458'
Corning Optical-036
RTPNW-2
412'
MHGB-W5T-048
Sedalia Rd
RTPNW-7
RTPNW-1
128'
NHWB-WYT-096
RTPNW-8
334'
Corning Optical-036
SouthernNet Inc

N
W E
S

BTI
OTHER COMPANY
BTI POP
BTI HANDHOLES
OTHER HANDHOLES
BTI MANHOLES
OTHER MANHOLES
BTI ROUTE
OTHER ROUTE
GROUNDED
NOT GROUNDED
BURIED

TOTAL ROUTE FOOTAGE
TOTAL CABLE FOOTAGE

DESCRIPTION	REV.	FOOTAGE	DUCTS	FIBER COUNT
As Built	1			

DATE	BY
5/28/03	JBS

BTI

DRAWING TITLE: RTP NW

DRAWING TYPE: Fiber Route Map

NOTES

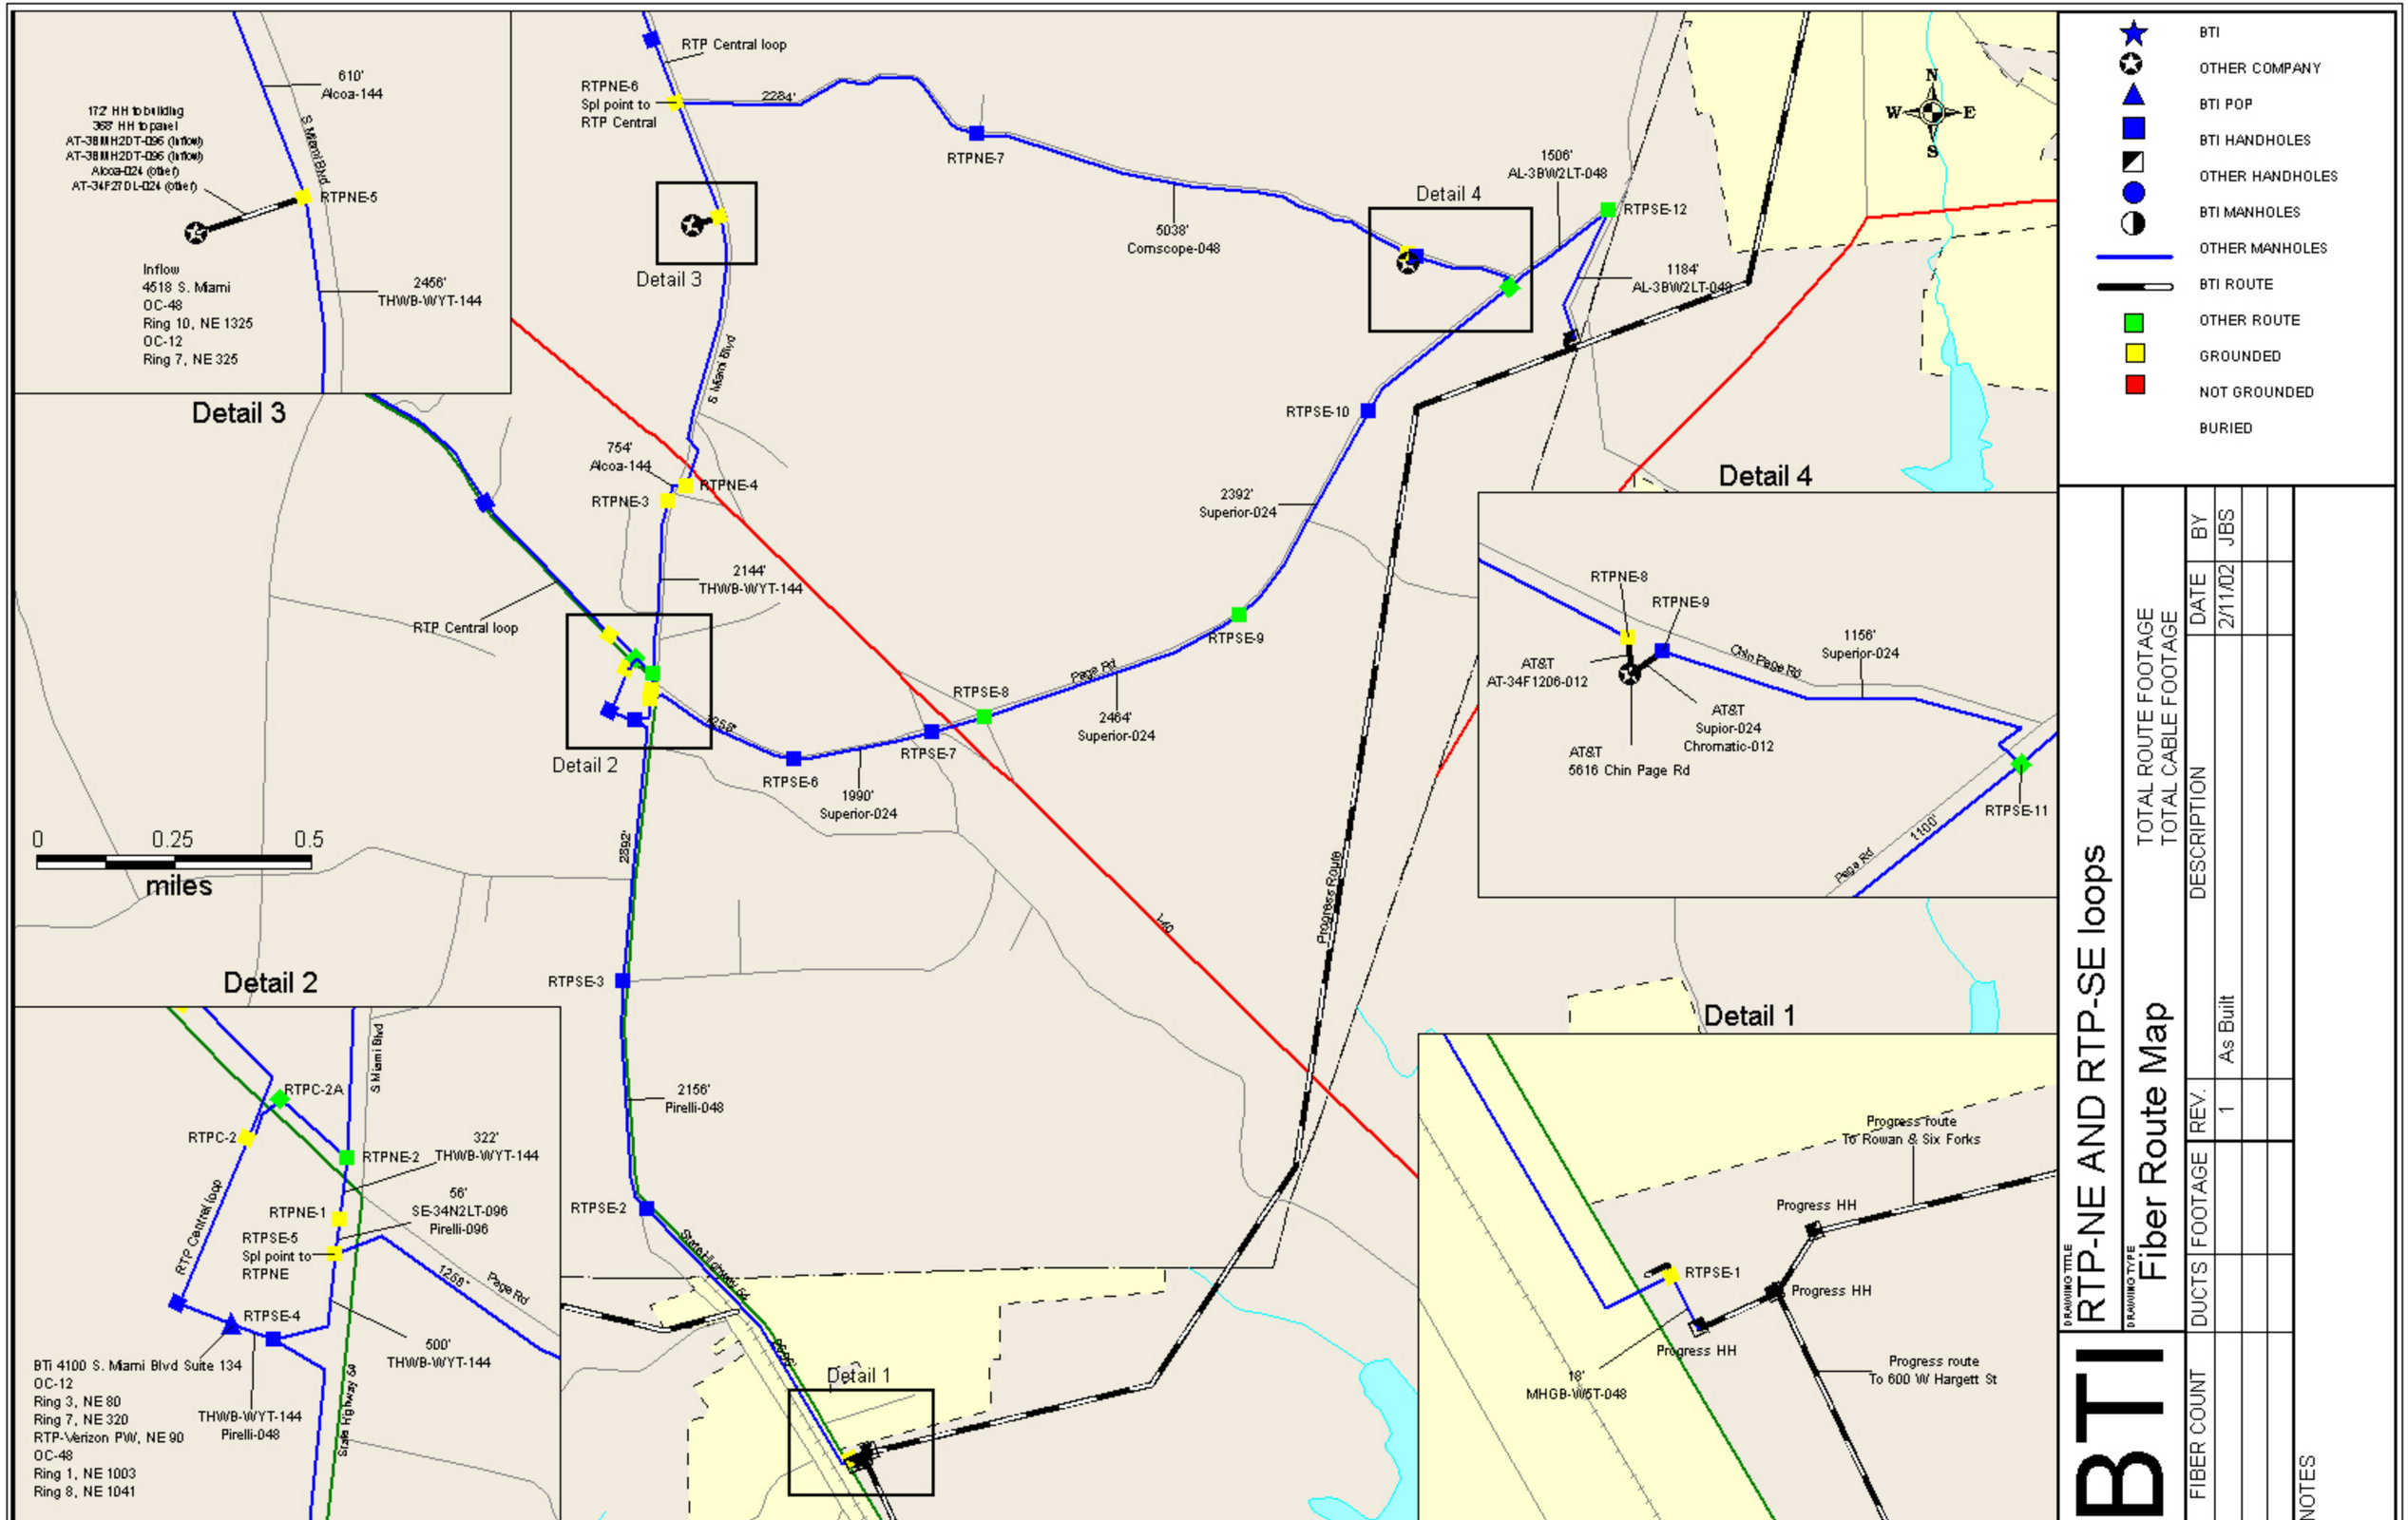

DRAWING TITLE
RTP-NE AND RTP-SE loops

DRAWING TYPE
Fiber Route Map

TOTAL ROUTE FOOTAGE
TOTAL CABLE FOOTAGE

FIBER COUNT	DUCTS	FOOTAGE	REV.	DESCRIPTION	DATE	BY
			1	As Built	2/11/02	JBS

NOTES

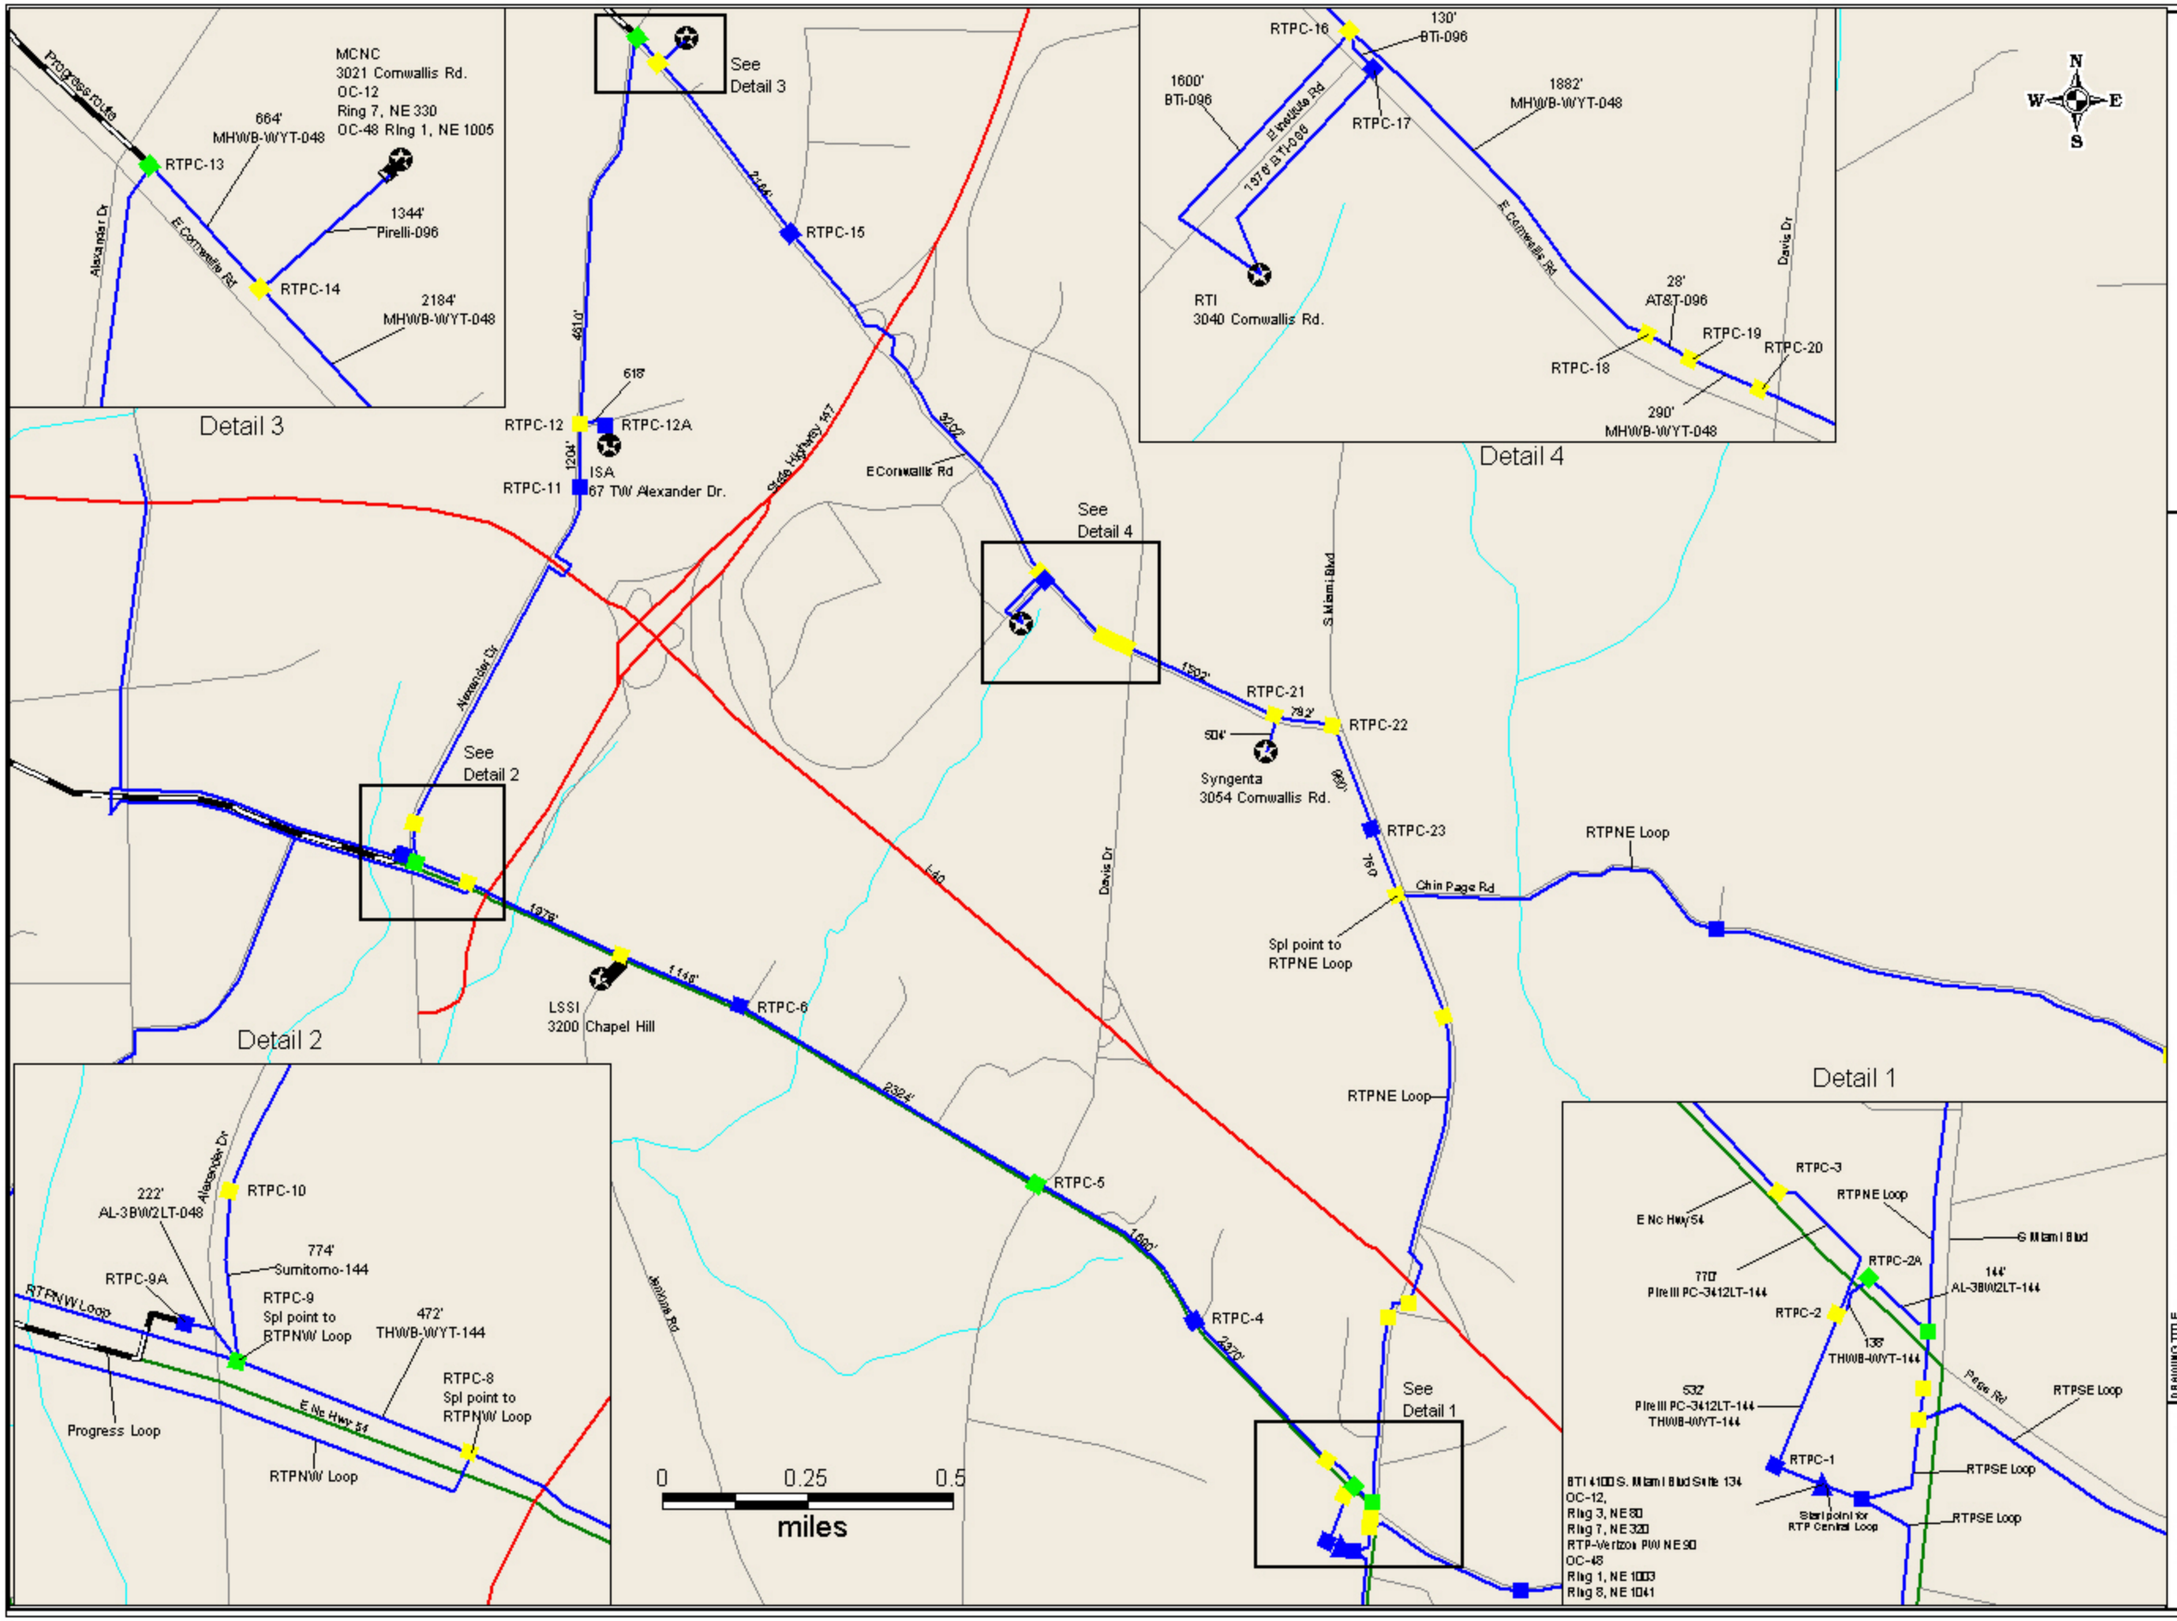

BTI
OTHER COMPANY
BTI POP
BTI HANDHOLES
OTHER HANDHOLES
BTI MANHOLES
OTHER MANHOLES
BTI ROUTE
OTHER ROUTE
GROUNDED
NOT GROUNDED
BURIED

TOTAL ROUTE FOOTAGE NA
TOTAL CABLE FOOTAGE NA

DRAWING TITLE
RTP Central Loop

DRAWING TYPE
Fiber Route Map

FIBER COUNT	DUCTS	FOOTAGE	REV.	DESCRIPTION	DATE	BY
			1	As Built	5/06/02	JBS

NOTES