LEGEND

- POLE
- IRON PIN
- MONUMENT
- STORM SEWER
- CURB LINE
- RIGHT-OF-WAY LINE
- CATCH BASIN
- WATER & SEWER MAINS
- SEWER MANHOLE
- WATER VALVE
- HYDRANT

RIGHT OF WAY WIDTH _____
WIDTH BETWEEN CURB FACES _____
CURB & GUTTER INSTALLED _____
PAVING INSTALLED _____
TYPE OF BASE _____ _____ IN. THICK
TYPE OF SURFACE
THICKNESS _____ IN.
RESURFACED _____

LEFT - N/S = ^
RIGHT - S/S = v

B.M. 359.29 SPIKE IN POLE S/E COR. SHOREHAM & CORNWALLIS RD.

— APPROVED —

W & S ENG.	WEW	DATE 4/10/80
DESIGN ENGR.	[illegible]	DATE 4/10/80
CONST. SUPERVISOR		DATE
STREET ENGR.	[illegible]	DATE
ASST. CITY ENGR.	[illegible]	DATE 4-15-80

NORTH CAROLINA PROFESSIONAL SEAL 3715 ENGINEER LARRY STEVENSON KERR

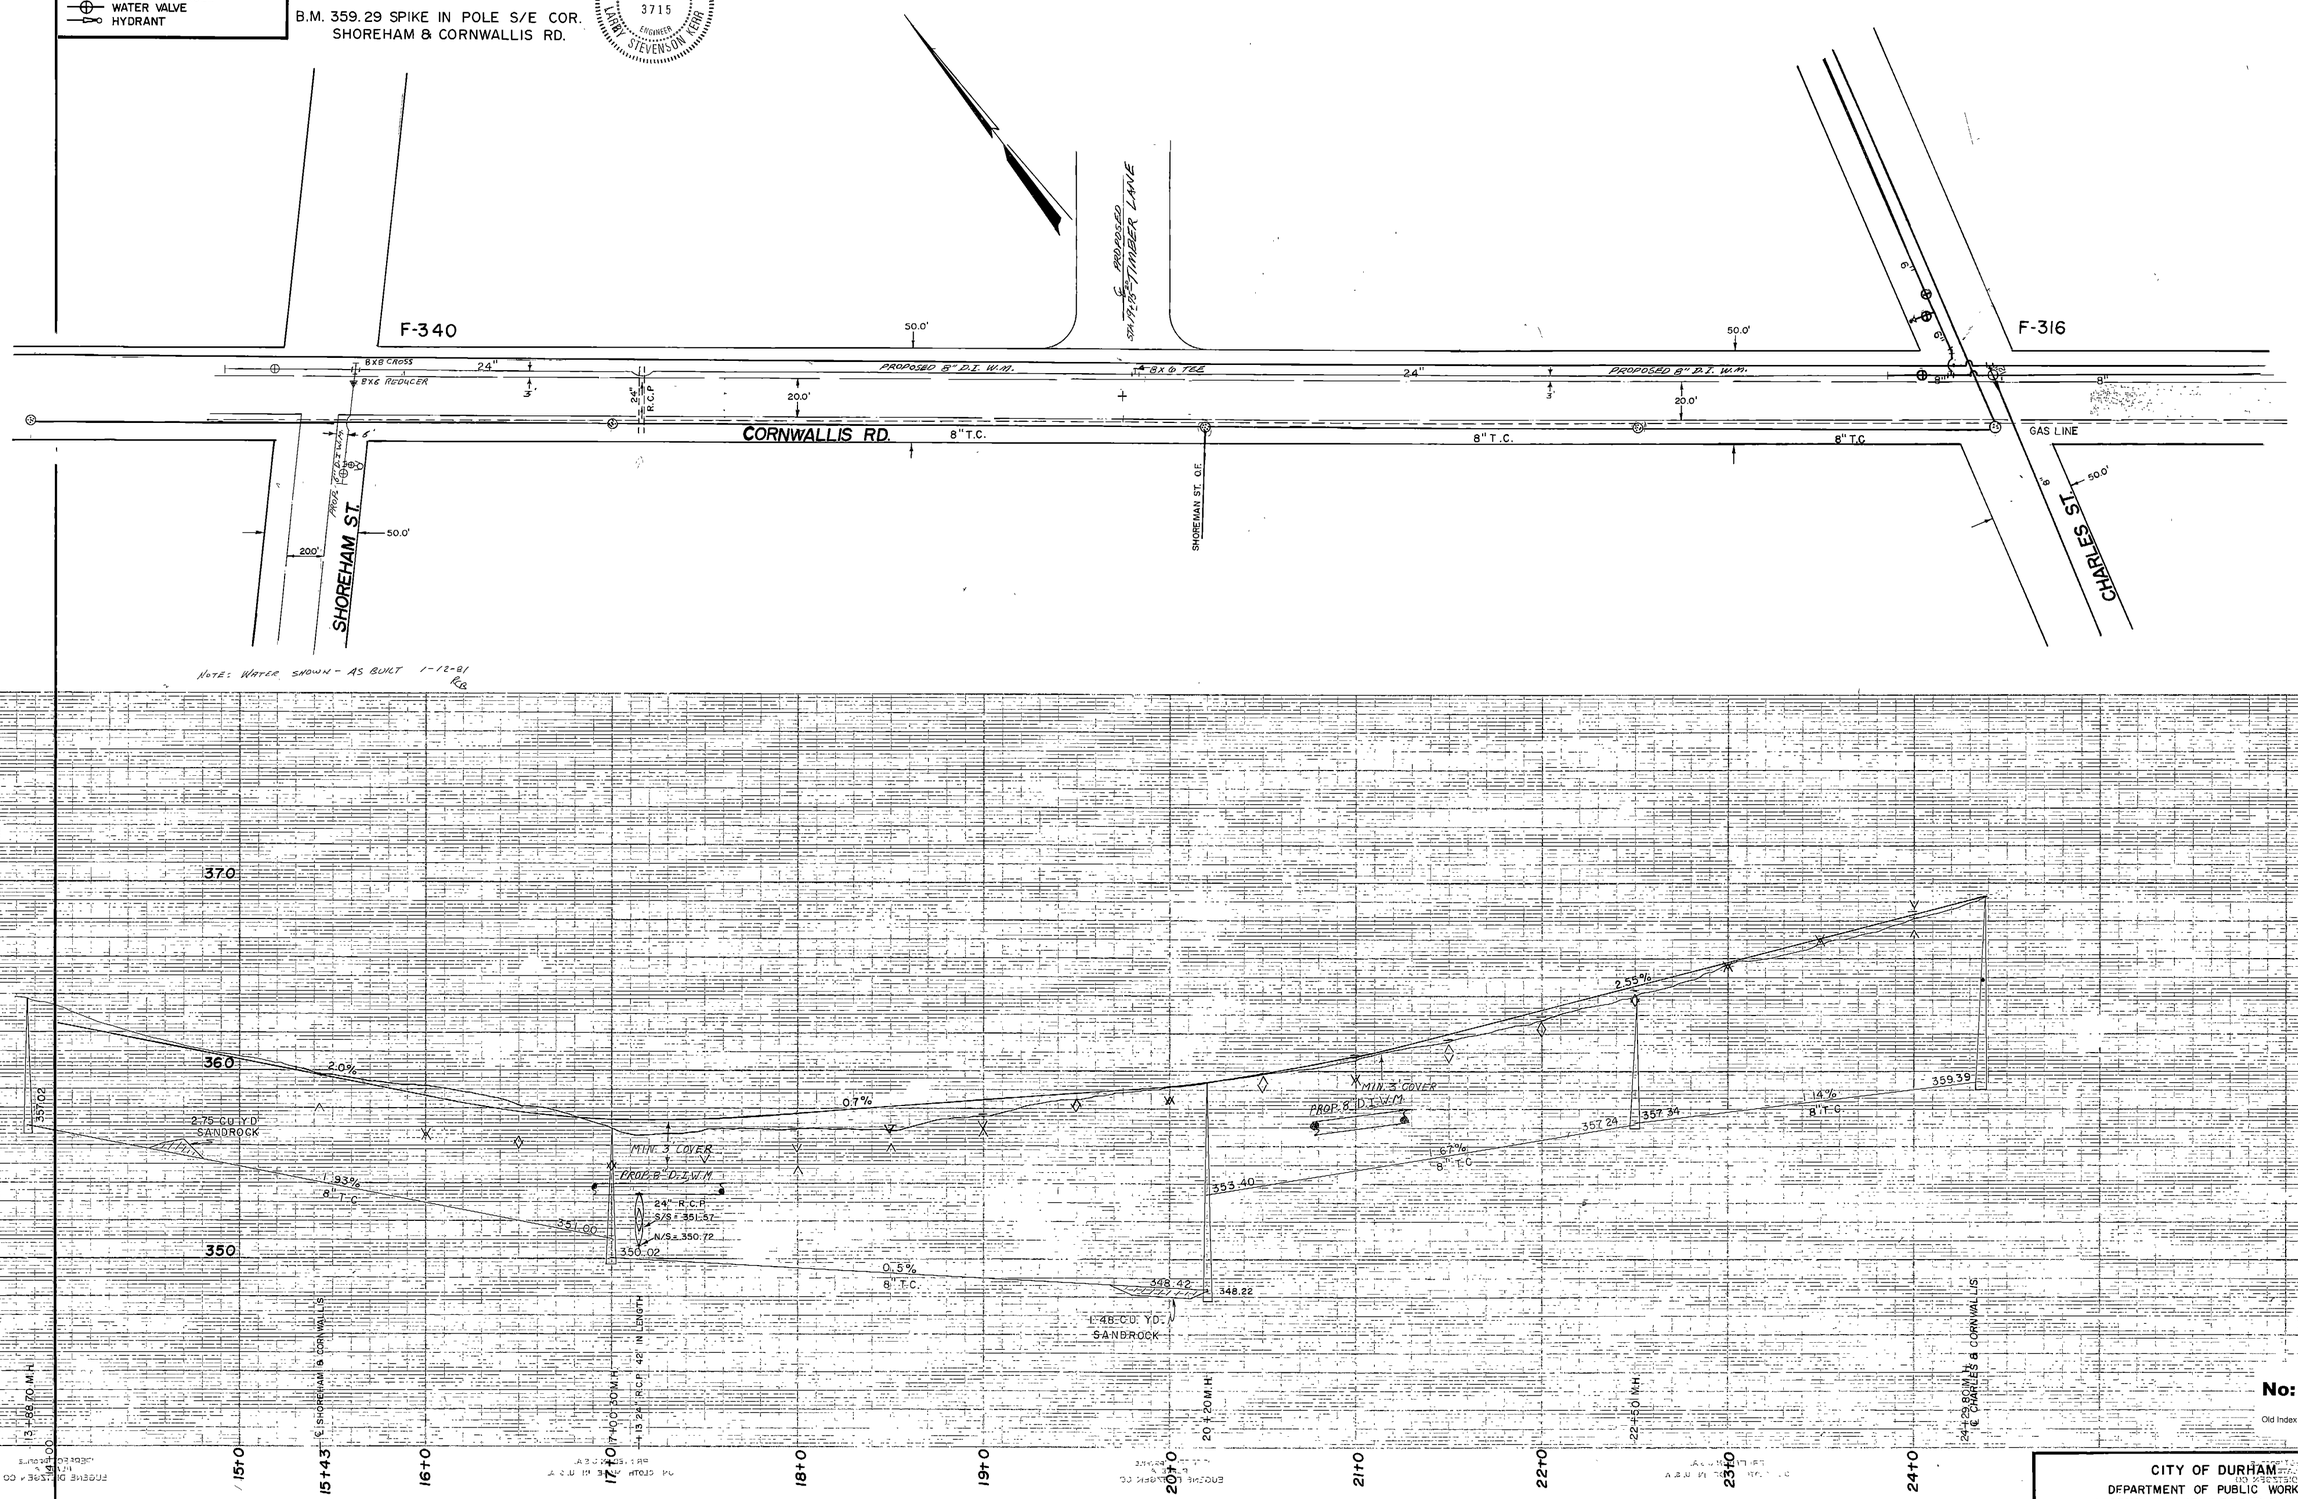

NOTE: WATER SHOWN - AS BUILT 1-12-81 RB

No: 4119

Old Index # C-35 (Water & Sewer)

AS BUILT
1/8/70

CITY OF DURHAM
DEPARTMENT OF PUBLIC WORKS
CORNWALLIS RD. ℄ PROFILE
FROM-SHOREHAM ST.
TO-CHARLES ST.
SCALE: HOR. 1" = 40', VER. 1" = 4'

SHEET NO.: C-35
DESIGNED BY:
DRAWN BY: R.L.C.